


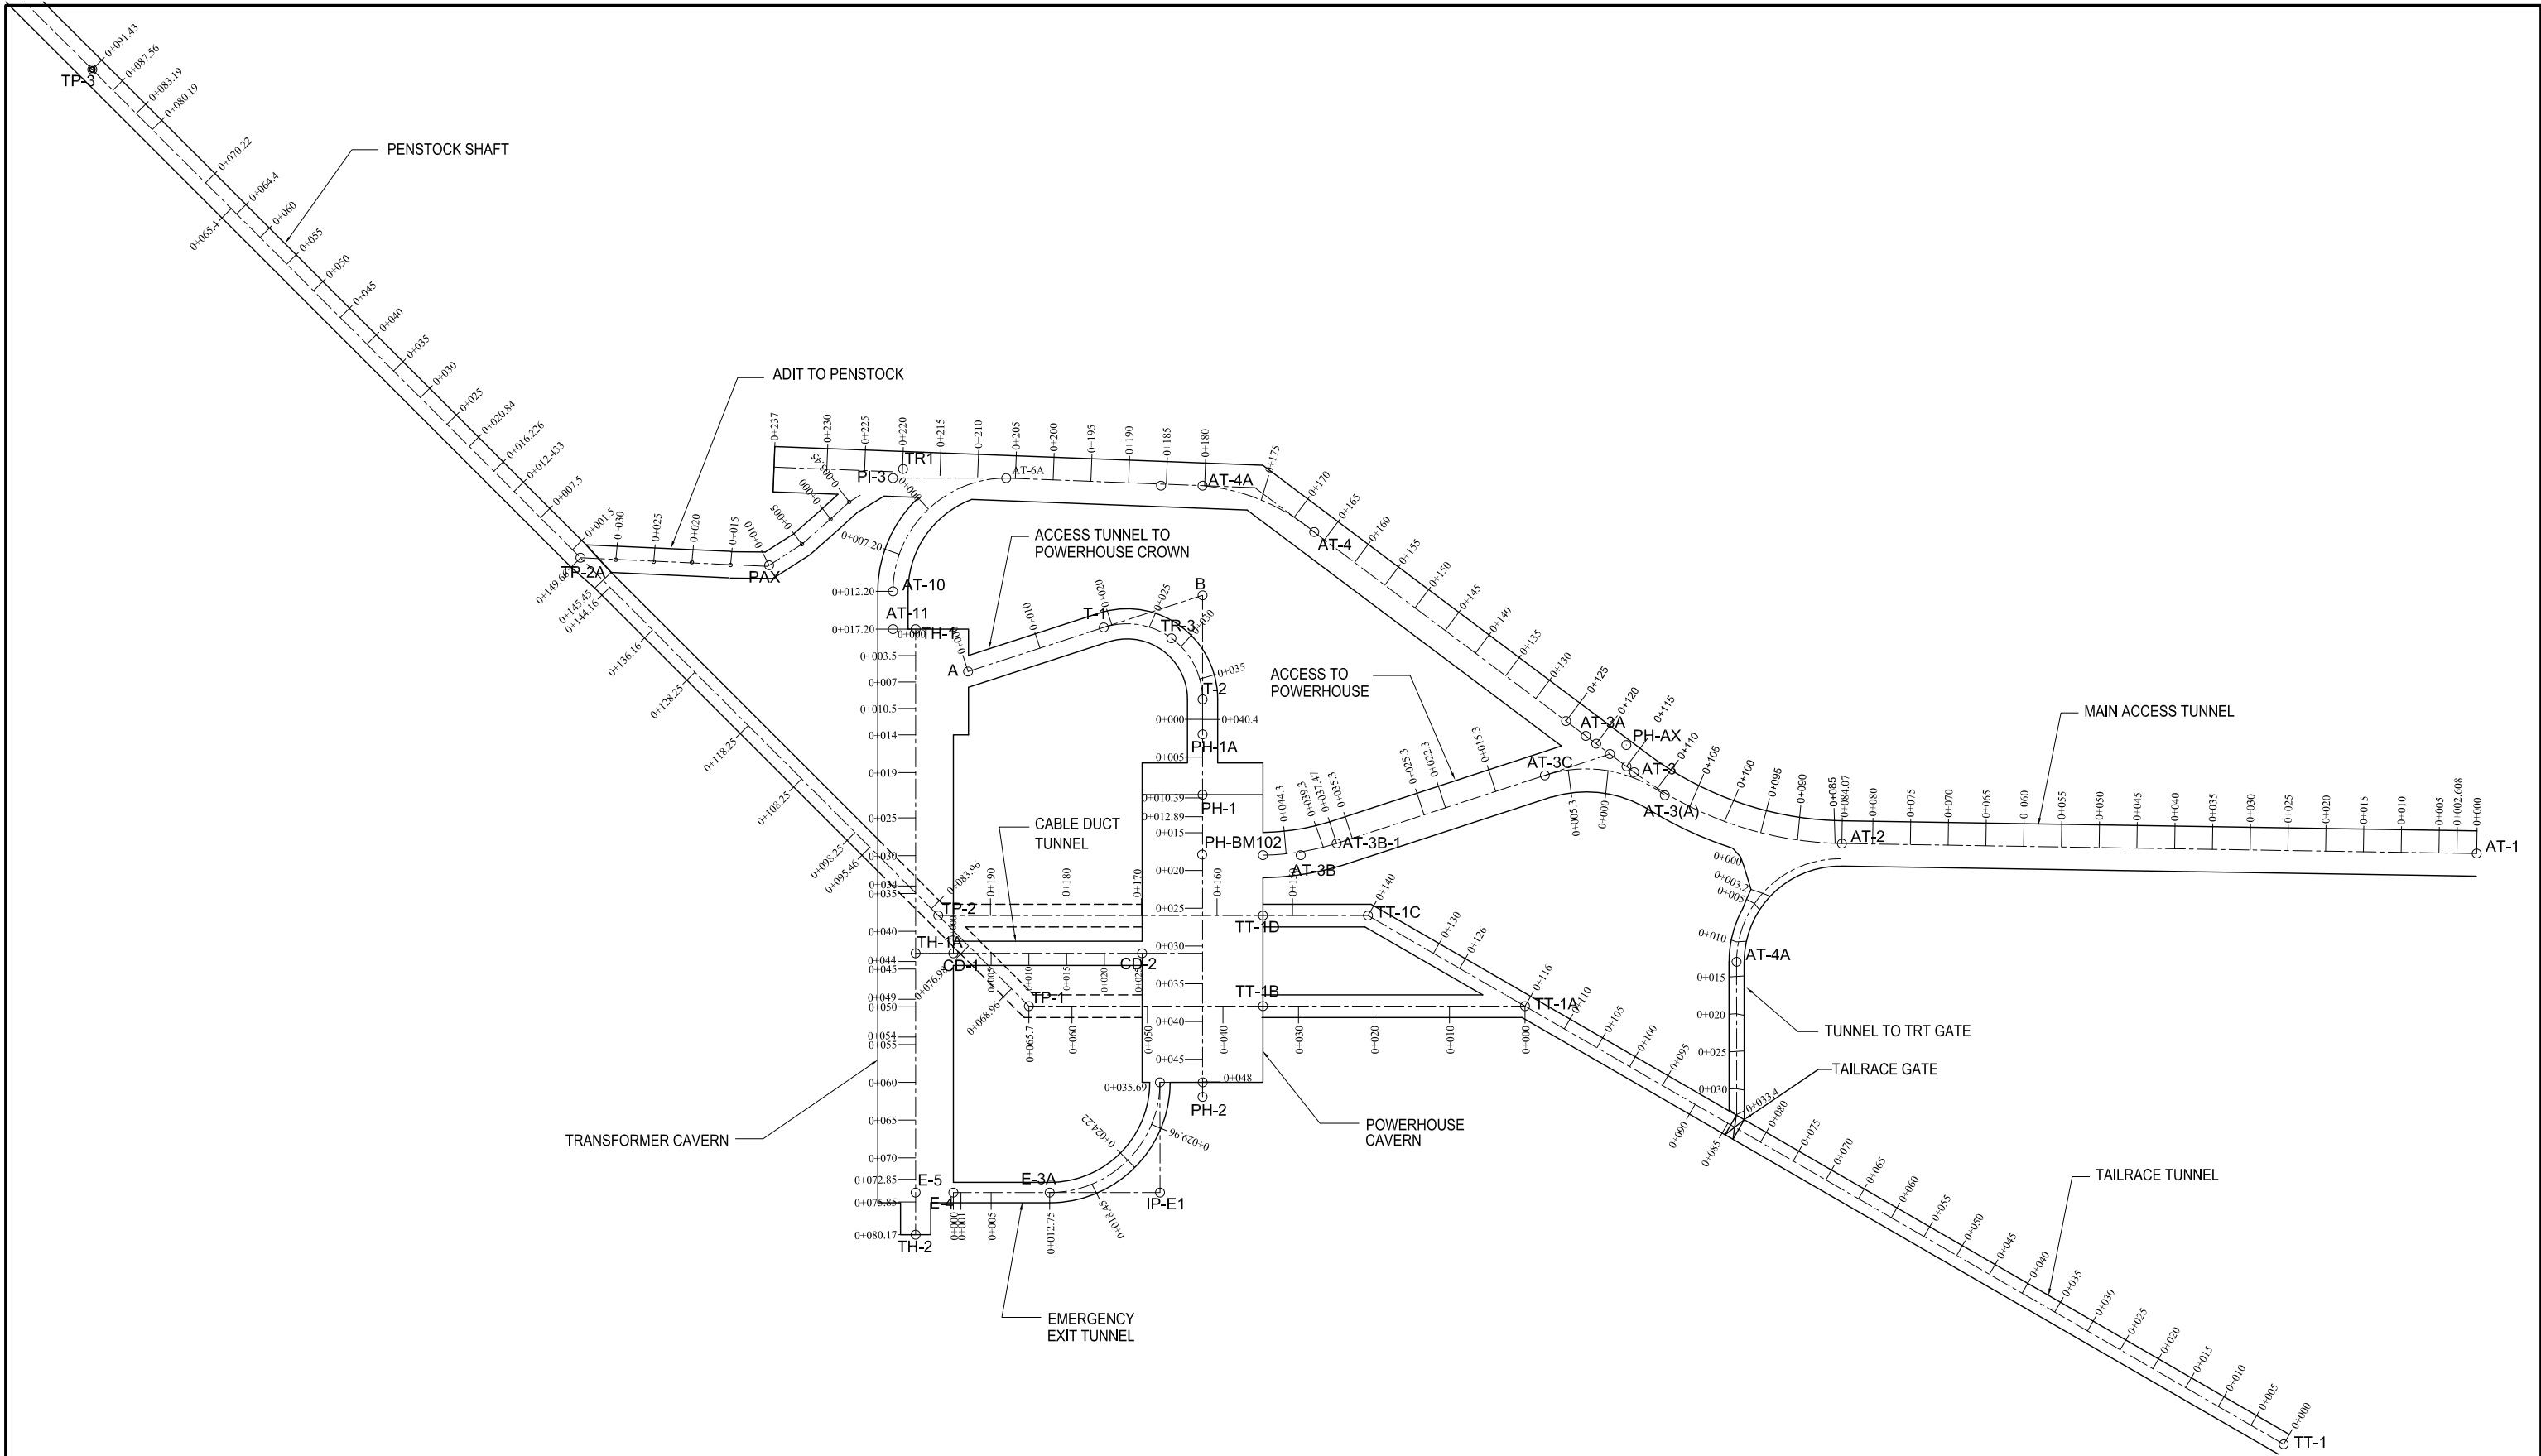

AS BUILT DRAWING		
CHILIME HYDROPOWER CO.LTD. CHILIME HYDROELECTRIC PROJECT		
TITLE: POWERHOUSE GENERAL LAYOUT PLAN		
PREPARED : SUJAN	RECOMMENDED :	SCALE:
DESIGNED :	APPROVED :	DRG. NO. : CHP-UG-305
CHECKED :	DATE : FEB., 2005	SHEET NO. : 1